

South Carolina Department of Health and Environmental Control
Office of Ocean and Coastal Resource Management
104 Parker Drive
Beaufort, South Carolina 29906

January 7, 2014
Permit Application Public Notice

Michelle Bezilla, OCRM-14-010-W

The Department has received an application for a permit for the alteration of a critical area. The application was submitted pursuant to the Coastal Zone Management Act (Act 123) of 1977 South Carolina General Assembly. The application in brief, is described as follows:

LOCATION: On and adjacent to Broad Creek at 56 Widewater Way, Spanish Wells Plantation, Hilton Head Island, Beaufort County, South Carolina. TMS: R510 010 000 0241 0000.

WORK: The work as proposed consists of making additions to an existing dock. Specifically, the applicant seeks to build a 13' x 13', four-pile boatlift floodside of the existing pierhead. The work as described is for private, recreational use.

This public notice is being distributed to all known interested persons and agencies to assist in developing facts on which a decision by the Department can be based. Comments concerning the proposed work must be submitted in writing, setting forth sufficient detail to furnish a clear understanding of the reasons for support or opposition.

Comments regarding this application must be received by the Department on or before **January 22, 2014**. For more information, please contact:
Paul Wojoski at 843-846-9400 or via email at wojoskpa@dhec.sc.gov.

NOTE: Plans depicting the proposed work are available and will be provided upon receipt of a written request or may be viewed on the Department website at **www.scdhec.gov/environment/ocrm/public_notice.htm**.



GASQUE & ASSOCIATES INC.
LAND SURVEYORS & PLANNERS


28 PROFESSIONAL VILLAGE CIRCLE, BEAUFORT, S.C.
P.O. BOX 1363, BEAUFORT, S.C.
PHONE (843) 522-1798

SHEET # 1 OF 3

THOMAS M. & BERNADETTE M.
BERNABEI
R510 010 000 0240 0000
2745 DUNKEITH DR NW
CANTON HO 44708

R510 010 000 02414 0000
MICHELLE BEZILLA
56 WIDEWATER WAY
HILTON HEAD SC, 29926

LINDA R. EPPERSON
R510 010 000 0242 0000
54 WIDEWATER WAY
HILTON HEAD S.C. 29926

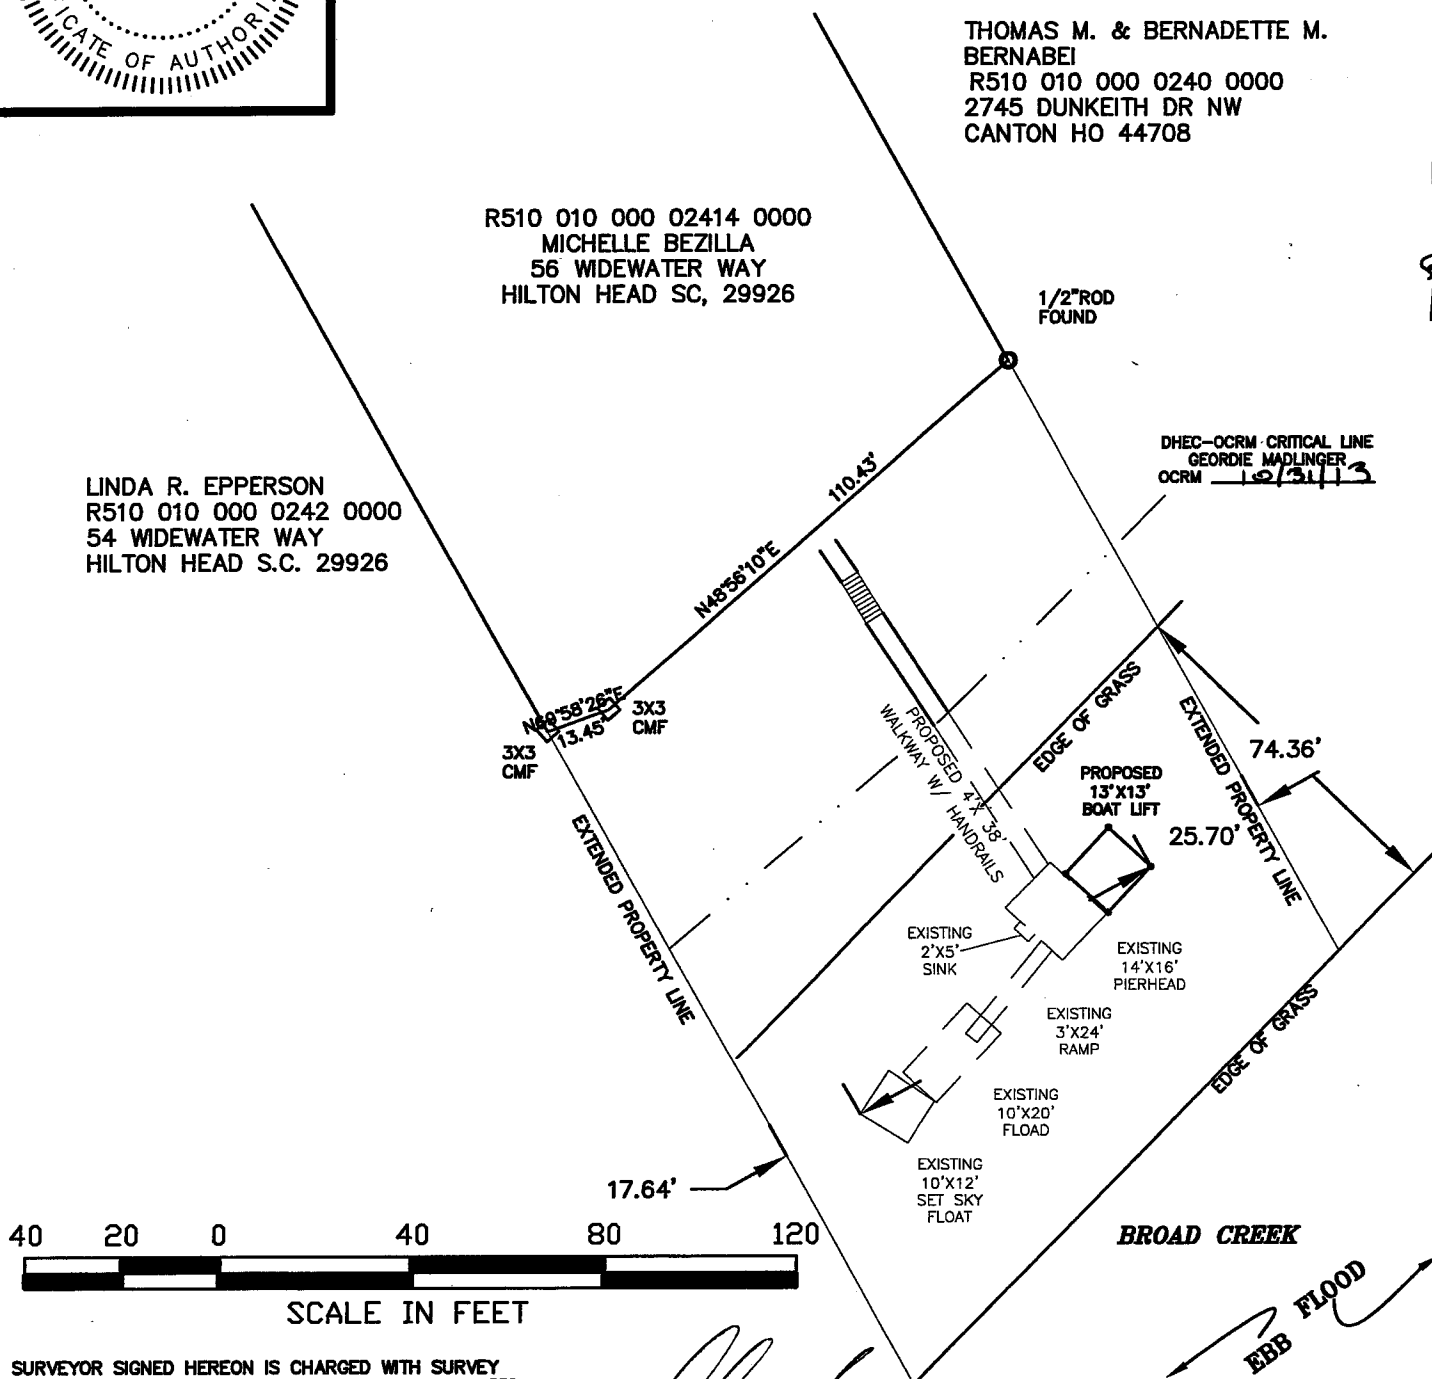

SURVEYOR SIGNED HEREON IS CHARGED WITH SURVEY MATTERS AND THE PHYSICAL DRAWING ON A COMPUTER DRAFTING SYSTEM ONLY. THIS IS NOT A DESIGN OR INTENDED TO BE ONE. ALL DEPICTIONS THAT ARE NOT SURVEY MATTERS IS PROVIDED BY OTHERS.

ADJACENT PROPERTY OWNERS:

1. THOMAS M. & BERNADETTE M. BERNABEI
R510 010 000 0240 0000
2745 DUNKEITH DR NW
CANTON HO 44708
2. LINDA R. EPPERSON
R510 010 000 0242 0000
54 WIDEWATER WAY
HILTON HEAD S.C. 29926

OCRN-14-010-W

SCALE: 1"=40'

R510 010 000 0241 0000
MICHELLE BEZILLA
56 WIDEWATER WAY
HILTON HEAD SC, 29926

**DOCK ASBUILT SURVEY
FOR PERMIT**

IN: BROAD CREEK
AT: SPANISH WELL HILTON HEAD

COUNTY OF: BEAUFORT
STATE: SOUTH CAROLINA

JOB# 40910 DSGN 7

DATE: 10/29/2013




GASQUE & ASSOCIATES INC.
LAND SURVEYORS & PLANNERS

28 PROFESSIONAL VILLAGE CIRCLE, BEAUFORT, S.C.
P.O. BOX 1363, BEAUFORT, S.C.
PHONE (843) 522-1798

SHEET # 2 OF 3

PLAN VIEW


DHEC-OCRM CRITICAL LINE
GEORDIE MADLINGER
OCRM 10/31/13

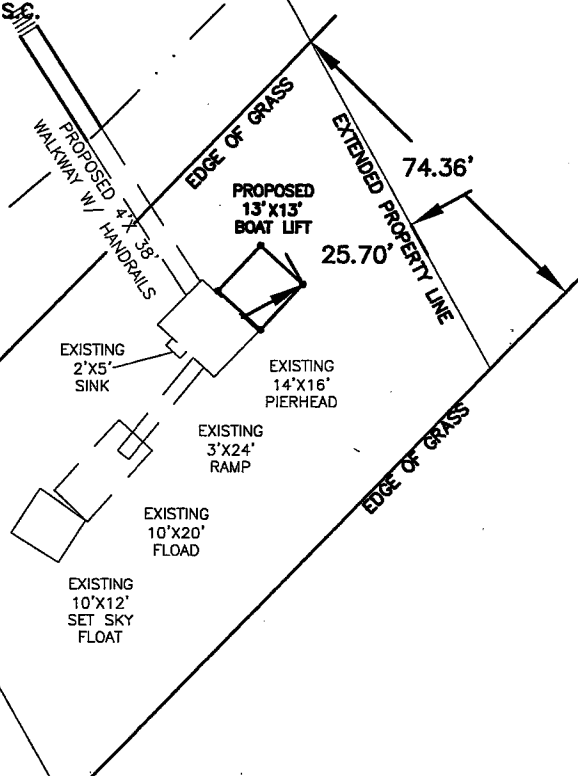

NOT TO SCALE

NOT TO SCALE

PROFILE VIEW

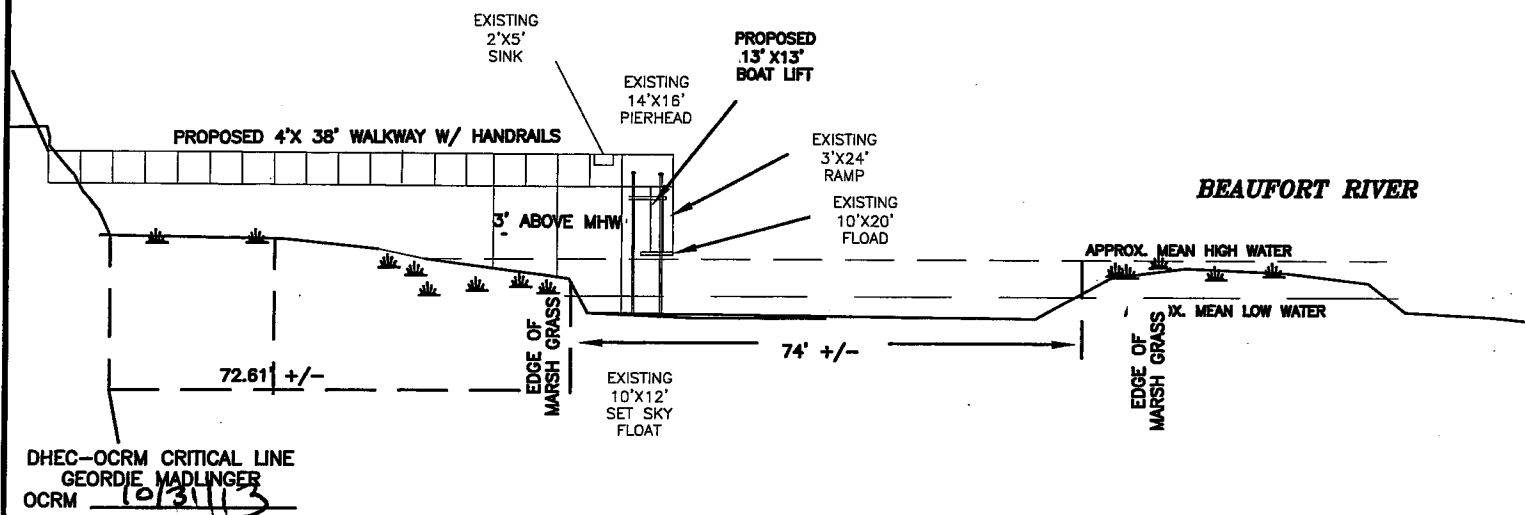

DHEC-OCRM CRITICAL LINE
GEORDIE MADLINGER
OCRM 10/31/13

SURVEYOR SIGNED HEREON IS CHARGED WITH SURVEY MATTERS AND THE PHYSICAL DRAWING ON A COMPUTER DRAFTING SYSTEM ONLY. THIS IS NOT A DESIGN OR INTENDED TO BE ONE. ALL DEPICTIONS THAT ARE NOT SURVEY MATTERS IS PROVIDED BY OTHERS.

Handwritten signature and date: 11-1-13

ADJACENT PROPERTY OWNERS:

1. THOMAS M. & BERNADETTE M. BERNABEI
R510 010 000 0240 0000
2745 DUNKEITH DR NW
CANTON HO 44708
2. LINDA R. EPPERSON
R510 010 000 0242 0000
54 WIDEWATER WAY
HILTON HEAD S.C. 29926

OCRM-14-010-W

R510 010 000 0241 0000
MICHELLE BEZILLA
56 WIDEWATER WAY
HILTON HEAD SC, 29926


**DOCK ASBUILT SURVEY
FOR PERMIT**

IN: BROAD CREEK
AT: SPANISH WELL HILTON HEAD

COUNTY OF: BEAUFORT
STATE: SOUTH CAROLINA

JOB# 40910 DSGN 7

DATE: 10/29/2013

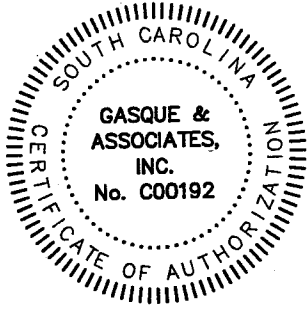

GASQUE & ASSOCIATES INC.
LAND SURVEYORS & PLANNERS

28 PROFESSIONAL VILLAGE CIRCLE, BEAUFORT, S.C.
P.O. BOX 1363, BEAUFORT, S.C.
PHONE (843) 522-1798


THOMAS M. & BERNADETTE M.
BERNABEI
R510 010 000 0240 0000
2745 DUNKEITH DR NW
CANTON HO 44708

R510 010 000 02414 0000
MICHELLE BEZILLA
56 WIDEWATER WAY
HILTON HEAD SC, 29926

LINDA R. EPPERSON
R510 010 000 0242 0000
54 WIDEWATER WAY
HILTON HEAD S.C. 29926

DHEC-OCRM CRITICAL LINE
THE AREA SHOWN ON THIS PLAT IS A REPRESENTATION OF DEPARTMENT PERMIT MATTERS AND THE PHYSICAL DRAWING ON A COMPUTER DRAFTING SYSTEM ONLY. THIS IS NOT A DESIGN OR INTENDED TO BE ONE. ALL DEPICTIONS THAT ARE NOT SURVEY MATTERS IS PROVIDED BY OTHERS.

SIGNATURE: *L. R. Epperson* DATE: 10/29/13
THE CRITICAL LINE SHOWN ON THIS PLAT IS VALID FOR FIVE YEARS FROM THE DATE OF THIS SIGNATURE, SUBJECT TO THE CAUTIONARY LANGUAGE ABOVE.

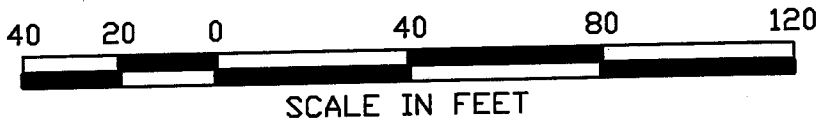

SURVEYOR SIGNED HEREON IS CHARGED WITH SURVEY MATTERS AND THE PHYSICAL DRAWING ON A COMPUTER DRAFTING SYSTEM ONLY. THIS IS NOT A DESIGN OR INTENDED TO BE ONE. ALL DEPICTIONS THAT ARE NOT SURVEY MATTERS IS PROVIDED BY OTHERS.

ADJACENT PROPERTY OWNERS:

1. THOMAS M. & BERNADETTE M. BERNABEI
R510 010 000 0240 0000
2745 DUNKEITH DR NW
CANTON HO 44708
2. LINDA R. EPPERSON
R510 010 000 0242 0000
54 WIDEWATER WAY
HILTON HEAD S.C. 29926

OCRM-14-010-W

SCALE: 1"=40'

R510 010 000 0241 0000
MICHELLE BEZILLA
56 WIDEWATER WAY
HILTON HEAD SC, 29926

**DOCK ASBUILT SURVEY
FOR PERMIT**

IN: BROAD CREEK
AT: SPANISH WELL HILTON HEAD

COUNTY OF: BEAUFORT
STATE: SOUTH CAROLINA

JOB# 40910 DSGN 7

DATE: 10/29/2013



GASQUE & ASSOCIATES INC.
LAND SURVEYORS & PLANNERS

SHEET # 3 OF 3

28 PROFESSIONAL VILLAGE CIRCLE, BEAUFORT, S.C.
P.O. BOX 1363, BEAUFORT, S.C.
PHONE (843) 522-1798



SURVEYOR SIGNED HEREON IS CHARGED WITH SURVEY MATTERS AND THE PHYSICAL DRAWING ON A COMPUTER DRAFTING SYSTEM ONLY. THIS IS NOT A DESIGN OR INTENDED TO BE ONE. ALL DEPICTIONS THAT ARE NOT SURVEY MATTERS IS PROVIDED BY OTHERS.

[Signature] 11-1-13

ADJACENT PROPERTY OWNERS:

1. THOMAS M. & BERNADETTE M. BERNABEI
R510 010 000 0240 0000
2745 DUNKEITH DR NW
CANTON HO 44708
2. LINDA R. EPPERSON
R510 010 000 0242 0000
54 WIDEWATER WAY
HILTON HEAD S.C. 29926

OCRM-14-010-W

R510 010 000 0241 0000
MICHELLE BEZILLA
56 WIDEWATER WAY
HILTON HEAD SC, 29926

**DOCK ASBUILT SURVEY
FOR PERMIT**

IN: BROAD CREEK
AT: SPANISH WELL HILTON HEAD

COUNTY OF: BEAUFORT
STATE: SOUTH CAROLINA

JOB# 40910 DSGN 7

DATE: 10/29/2013